


DO NOT SCALE DRAWINGS.
 CONTRACTOR MUST VERIFY ALL MEASUREMENTS ON SITE
 AND REPORT ANY DISCREPANCIES TO THE CONSULTANT
 BEFORE PROCEEDING WITH THE WORK.
 ALL WORK IS TO BE DONE IN ACCORDANCE WITH ALL
 GOVERNING CODES AND LOCAL BUILDING AUTHORITIES.
 DESIGNER IS NOT RESPONSIBLE FOR ANY FAILURES IN
 MATERIALS OR ERRORS CAUSED BY WORKMANSHIP OR
 DEVIATION FROM THIS DRAWING.
 THE DESIGNS AND DRAWINGS SHALL REMAIN THE
 PROPERTY OF THE CONSULTANT AND SHALL NOT BE
 ALTERED OR REPRODUCED WITHOUT THE CONSENT OF
 THE CONSULTANT.

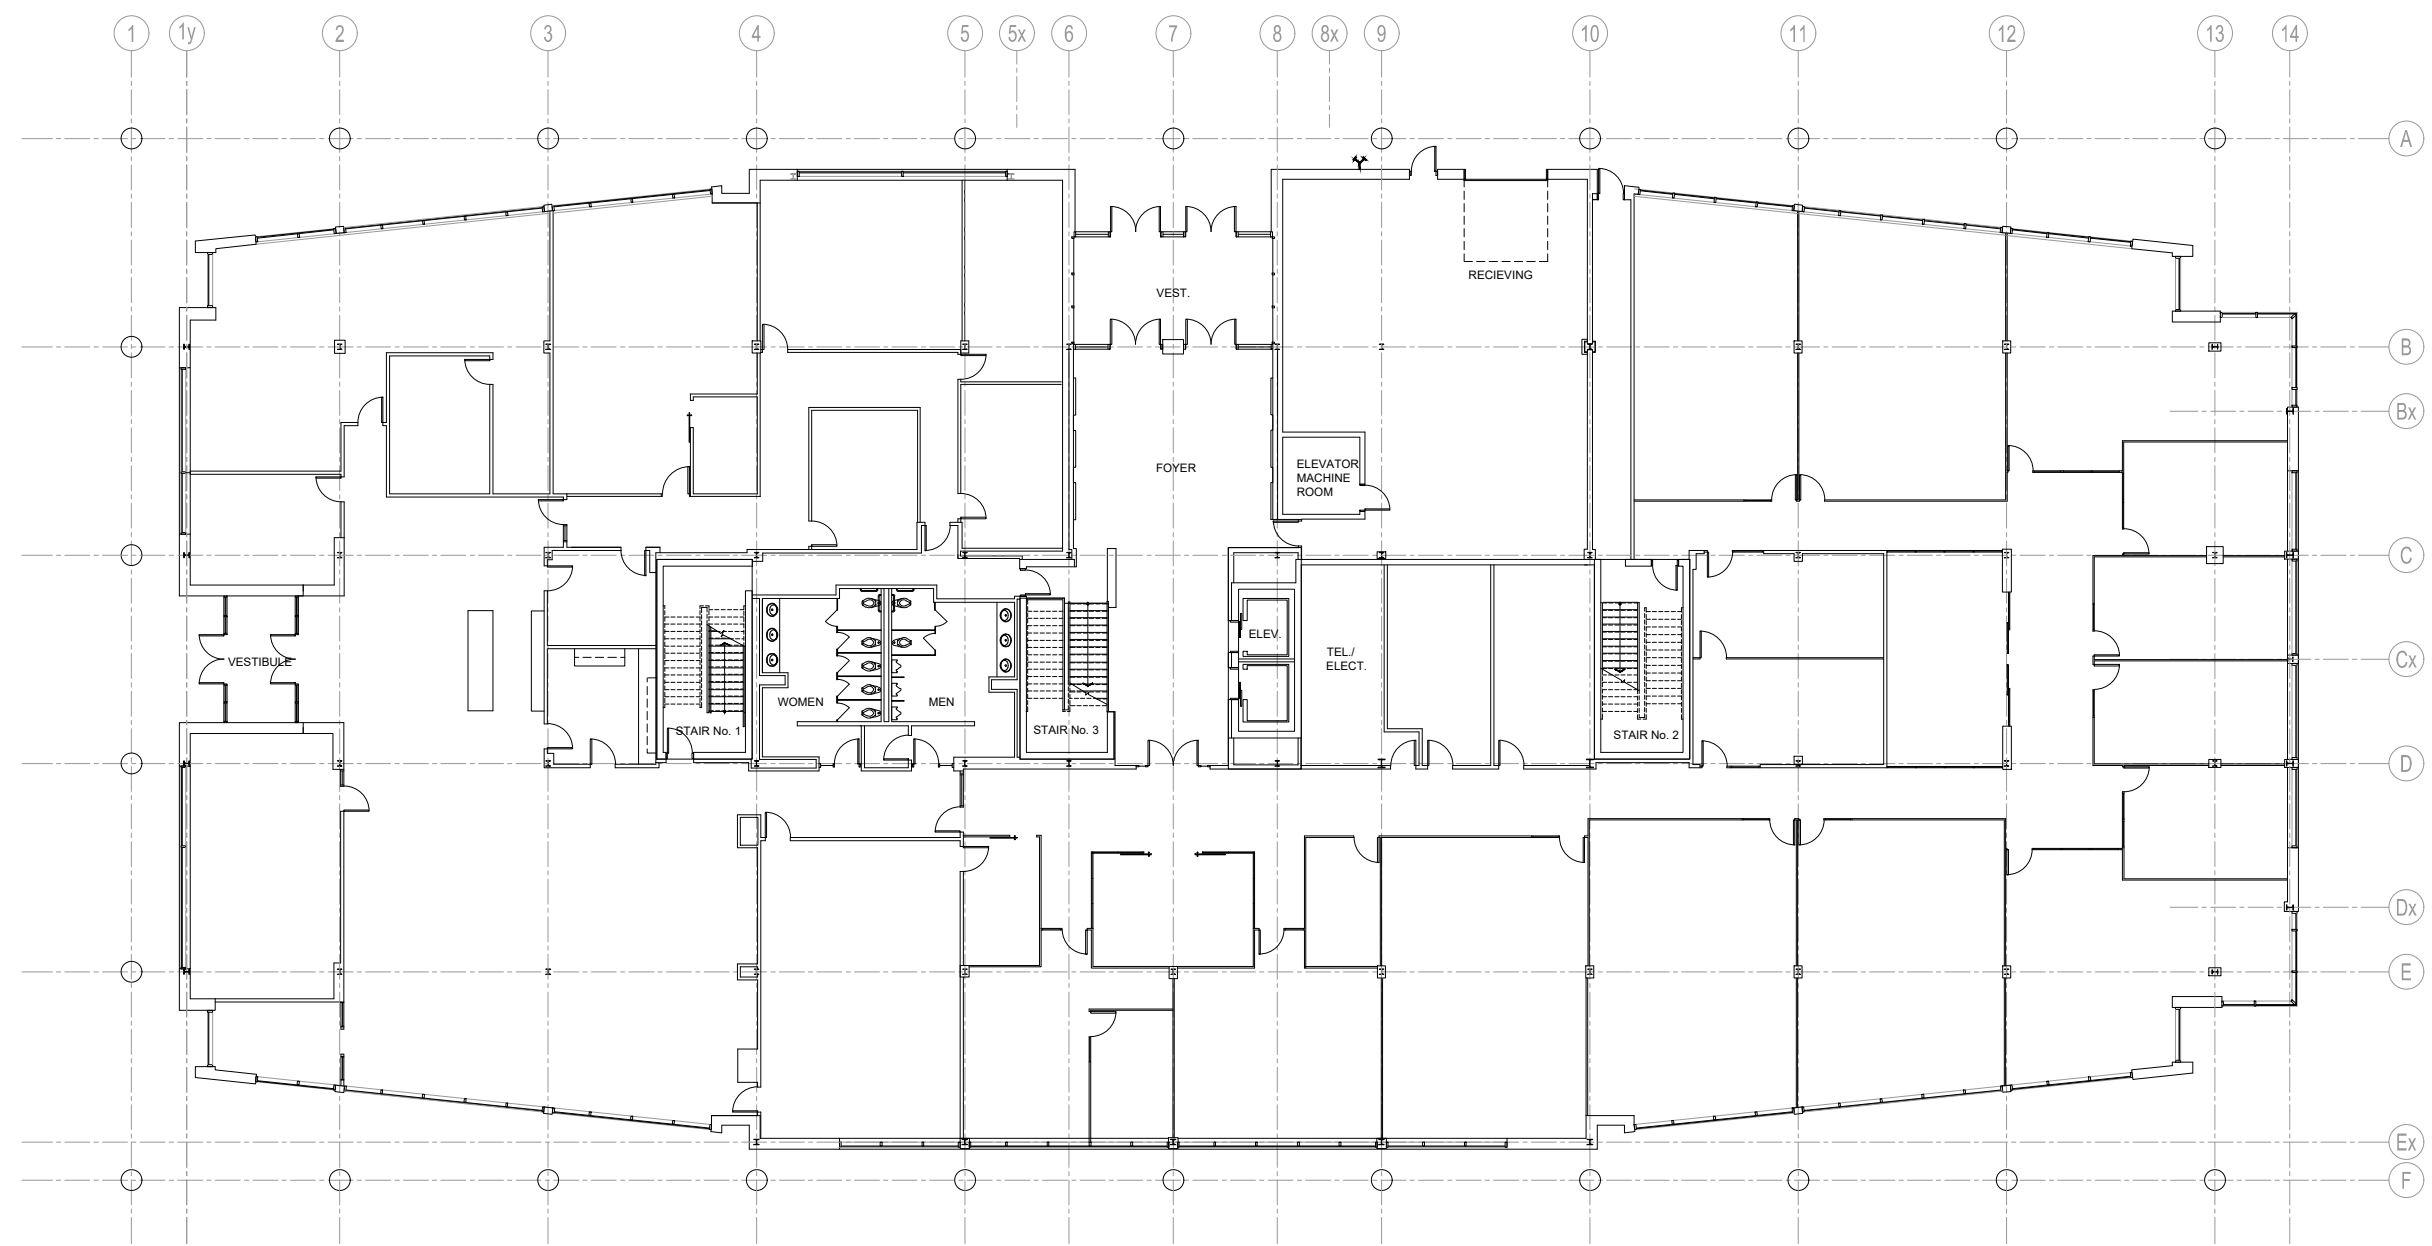

No.	Issued/Revised	Date	By

Dimensions

Dimensions 1995 Inc. Strathroy, ON
 519 245 4147 www.dimensions-ca.com

Sample Office Building

Laser Meseured Floor Plan
 / As-Built Plan

Scale: 1/8"=1'-0"
 Date: 2022 01 31
 Drawn: D.Van Haaren

A1