



DO NOT SCALE DRAWINGS.
 CONTRACTOR MUST VERIFY ALL MEASUREMENTS ON SITE AND REPORT ANY DISCREPANCIES TO THE CONSULTANT BEFORE PROCEEDING WITH THE WORK.
 ALL WORK IS TO BE DONE IN ACCORDANCE WITH ALL GOVERNING CODES AND LOCAL BUILDING AUTHORITIES. DESIGNER IS NOT RESPONSIBLE FOR ANY FAILURES IN MATERIALS OR ERRORS CAUSED BY WORKMANSHIP OR DEVIATION FROM THIS DRAWING.
 THE DESIGNS AND DRAWINGS SHALL REMAIN THE PROPERTY OF THE CONSULTANT AND SHALL NOT BE ALTERED OR REPRODUCED WITHOUT THE CONSENT OF THE CONSULTANT.

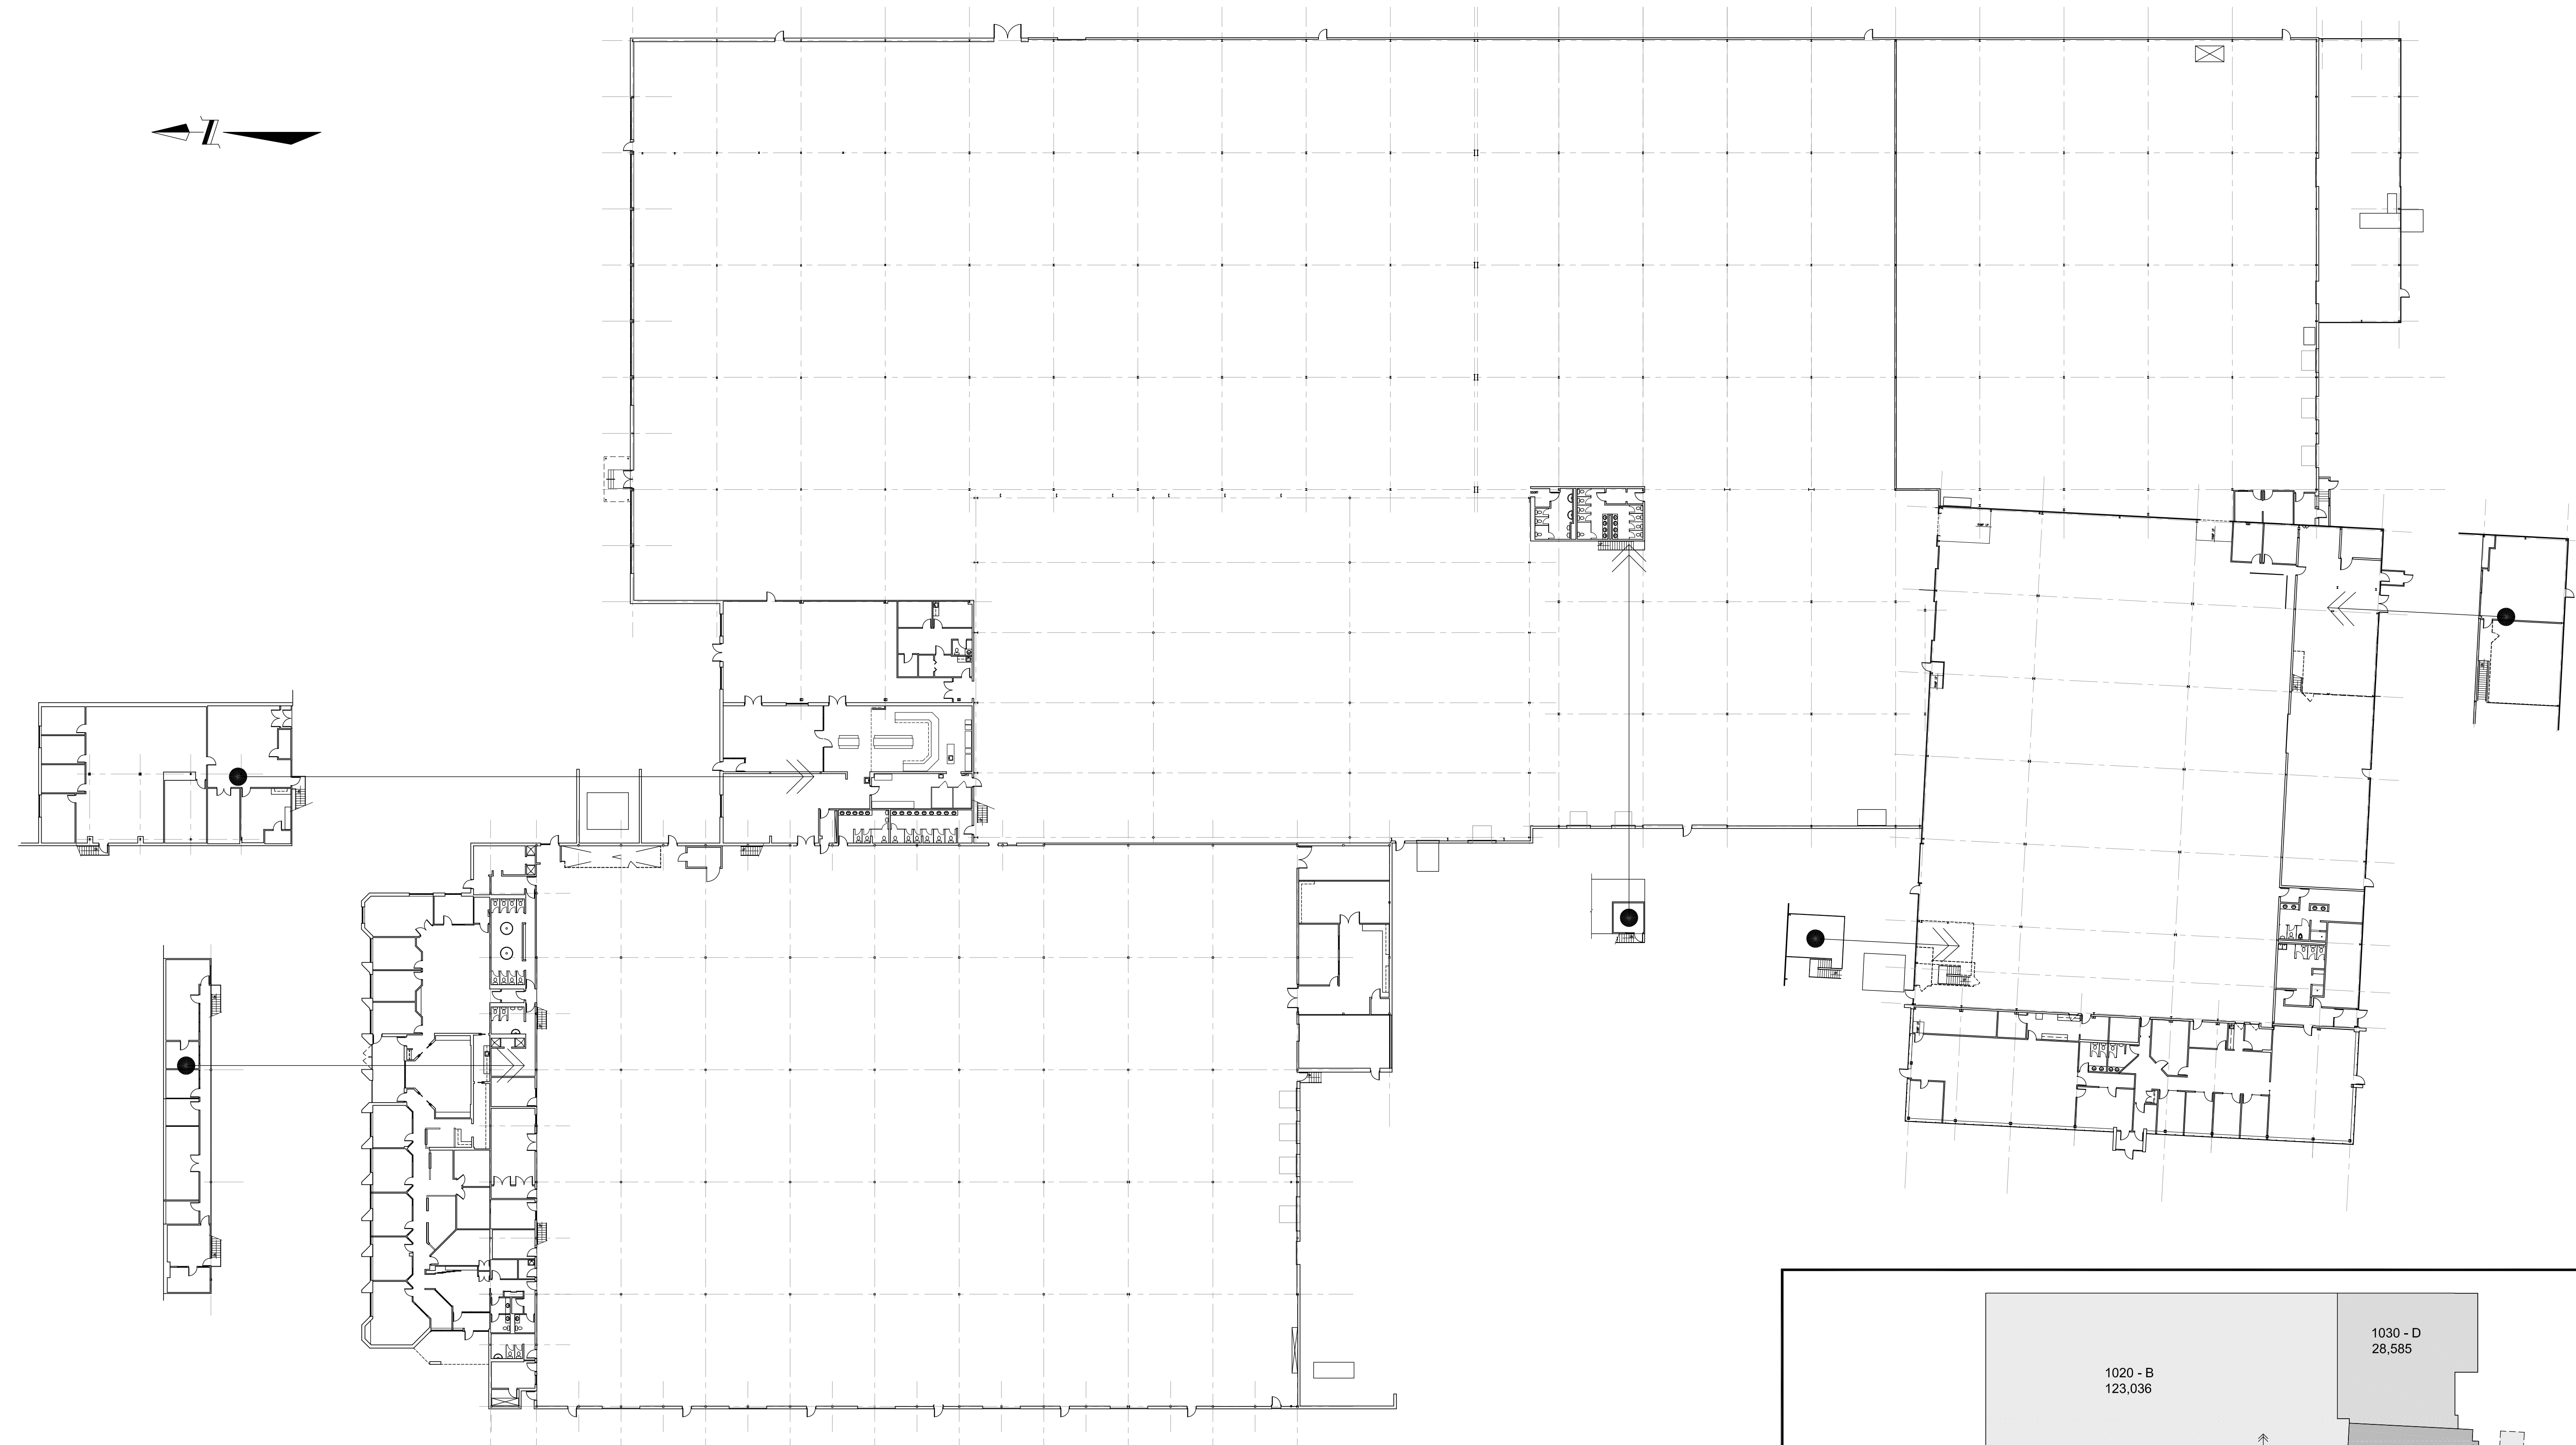


No.	Issued/Revised	Date	By

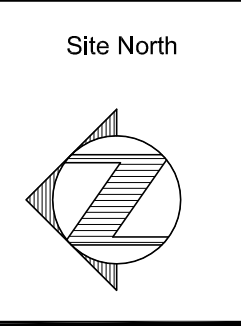

Dimensions
 254 Albert St., Strathroy, Ontario, N7G 1W5
 Tel: (519) 245-4147 Fax: (519) 245-4148
 www.dimensions-ca.com

Project
Sample Industrial Building
 100 Main Street
 London, ON

Drawing Title
**As-built
 Floor Plans and
 Area Summary**

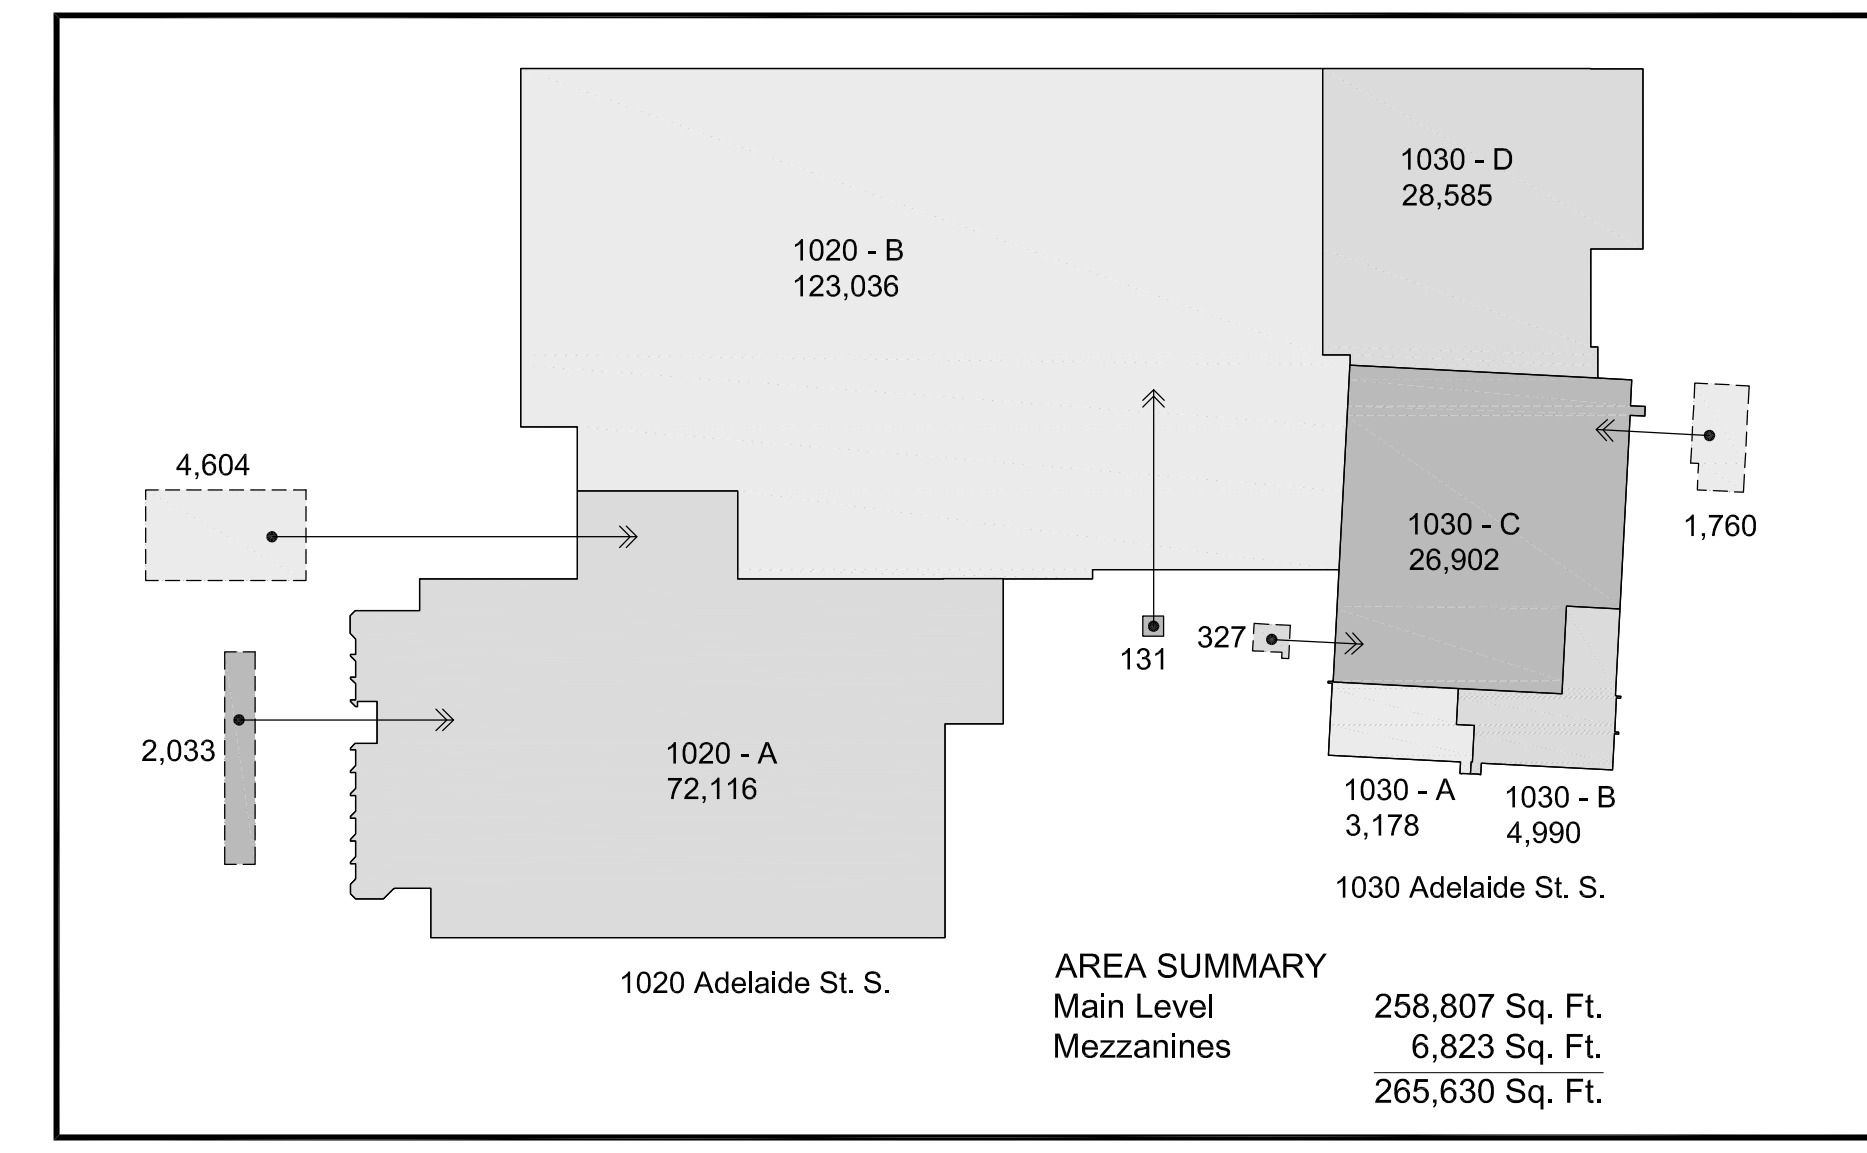

AREA SUMMARY

Main Level	258,807 Sq. Ft.
Mezzanines	6,823 Sq. Ft.
Total	265,630 Sq. Ft.

Scale	1" = 30'-0"	Drawing No.	1 of 1
Project Date			
Drawn by	D. Van Haaren		
Project #			
File Name			